

STATE ENGINEER
Salem, Oregon

4708
MAR 1952 Well Record

STATE WELL NO. 6/2W-33N(1)
COUNTY Marion
APPLICATION NO. GR-1071

GR- 1033

OWNER: J. L. McDonald


MAILING ADDRESS: 5830 VanCleave Rd.

LOCATION OF WELL: Owner's No.

CITY AND STATE: Salem, Oregon

SW 1/4 SW 1/4 Sec. 33 T. 6 S., R. 2 W., W.M.

Bearing and distance from section or subdivision corner N70°37'E. 1029' from SW cor. Sec. 33.

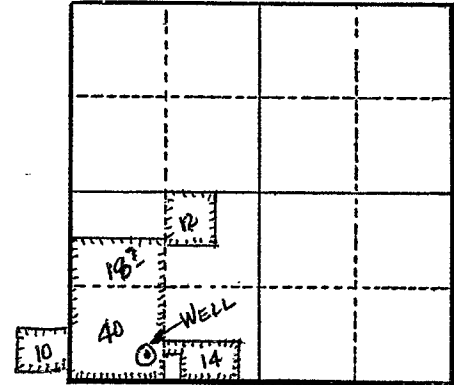

Section 33

Altitude at well 160 ft.

TYPE OF WELL: Drilled Date Constructed 1952

Depth drilled 136 ft. Depth cased 136 ft.

CASING RECORD:

8 inch

FINISH:

Perforated - 80 to 90 ft.
100 to 105 ft.
121 to 136 ft.

AQUIFERS:

WATER LEVEL:

23 ft.

PUMPING EQUIPMENT: Type Berkeley turbine H.P. 15
Capacity 300 G.P.M.

WELL TESTS:

Drawdown 50 ft. after 290 hours G.P.M.
Drawdown ft. after hours G.P.M.

USE OF WATER Irrigation Temp. °F. 19

SOURCE OF INFORMATION G.R. Record

DRILLER or DIGGER R. Stadel & Son

ADDITIONAL DATA:

Log N.A. Water Level Measurements Chemical Analysis Aquifer Test

REMARKS:

Irrigation of 94.7 acres.