

STATE ENGINEER
Salem, Oregon

MAR 1970

Well Record

STATE WELL NO. 6/2W-33P(1)
COUNTY Marion
APPLICATION NO. GR-1072

GR- 1034

OWNER: Perry E. Sanders


MAILING ADDRESS: 5946 VanCleave Rd.

LOCATION OF WELL: Owner's No.

CITY AND STATE: Salem, Oregon

SE 1/4 SW 1/4 Sec. 33 T. 6 S., R. 2 W., W.M.

Bearing and distance from section or subdivision corner 1100' N. & 1450' E. from SW cor. Sec. 33.

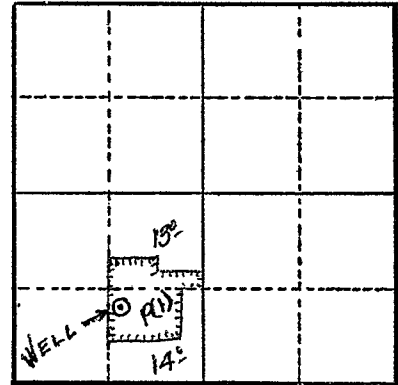

Section 33

Altitude at well 160 ft.

TYPE OF WELL: Drilled Date Constructed 1930

Depth drilled 104 ft. Depth cased 104 ft.

CASING RECORD:

6 inch

FINISH:

AQUIFERS:

WATER LEVEL:

27 ft. (2 - 54)

PUMPING EQUIPMENT: Type Berkeley 4" turbine H.P. 5

Capacity 80 G.P.M.

WELL TESTS:

Drawdown 88 ft. after 60 hours G.P.M.

Drawdown 54 ft. after 42 hours G.P.M.

USE OF WATER Irrigation Temp. °F., 19

SOURCE OF INFORMATION G.R. Record

DRILLER or DIGGER

ADDITIONAL DATA:

Log N.A. Water Level Measurements Chemical Analysis Aquifer Test

REMARKS:

Irrigation of 27 acres.