

STATE ENGINEER
Salem, Oregon

MAR 14 1952

Well Record


STATE WELL NO. 4/1W-12N
COUNTY MARION
APPLICATION NO. GR-2949

OWNER: John Thomas Miller

MAILING ADDRESS: P. O. Box 198 Pg 1 of 4
CITY AND STATE: Aurora, Oregon

LOCATION OF WELL: Owner's No. _____
SW 1/4 SW 1/4 Sec. 12 T. 4 S. R. 1 W., W.M.

Bearing and distance from section or subdivision corner 1200' N & 730' E from SW cor of Sec 12

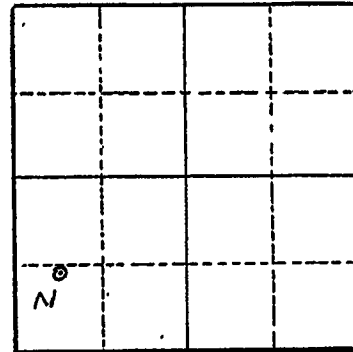

Section 12

Altitude at well _____

TYPE OF WELL: Drilled Date Constructed 1952

Depth drilled 68' Depth cased 68'

CASING RECORD:

10'

FINISH:

AQUIFERS:

WATER LEVEL:

20'

PUMPING EQUIPMENT: Type Fairbanks, Morse H.P. 5
Capacity 80 G.P.M.

WELL TESTS:
Drawdown 45 ft. after _____ hours 280 G.P.M.
Drawdown _____ ft. after _____ hours _____ G.P.M.

USE OF WATER Irrigation Temp. _____ °F., 19

SOURCE OF INFORMATION GR-3949

DRILLER or DIGGER _____

ADDITIONAL DATA:
Log Water Level Measurements _____ Chemical Analysis _____ Aquifer Test _____

REMARKS:

STATE ENGINEER
Salem, Oregon

Well Record

STATE WELL NO. 4/1W-12N(1)
COUNTY Marion
APPLICATION NO. CR 274A

MARI 472

OWNER: J. T. Miller

MAILING ADDRESS:

LOCATION OF WELL: Owner's No.

CITY AND STATE:

Pg 3 of 4

..... 1/4 1/4 Sec. T. N. E. S., R. W., W.M.

Bearing and distance from section or subdivision corner

Altitude at well 145

TYPE OF WELL: Drilled Date Constructed 1952

Depth drilled 68 Depth cased

Section

CASING RECORD:

10 inch

FINISH:

AQUIFERS:

Gravel from 64 to 68

WATER LEVEL:

20 feet below land surface on May, 1952

PUMPING EQUIPMENT: Type Turbine H.P. 5
Capacity G.P.M.

WELL TESTS:

Drawdown ft. after hours G.P.M.
Drawdown ft. after hours G.P.M.

USE OF WATER Irrigation--8 acres Temp. °F., 19

SOURCE OF INFORMATION USGS

DRILLER or DIGGER

ADDITIONAL DATA:

Log Water Level Measurements Chemical Analysis Aquifer Test

REMARKS:

