

STATE ENGINEER
Salem, Oregon

MARI... 33

Well Record

STATE WELL NO. 6/2W-34A
COUNTY Marion
APPLICATION NO. GR-1567

GR- 1509

OWNER: M. B. Gilchrist


MAILING ADDRESS: Rt. 2, Box 468

LOCATION OF WELL: Owner's No. #1

CITY AND STATE: Salem, Oregon

NE 1/4 NE 1/4 Sec. 34 T. 6 S., R. 2 W., W.M.

Bearing and distance from section or subdivision corner 300' W. & 1100' S. from NE cor. Sec. 34

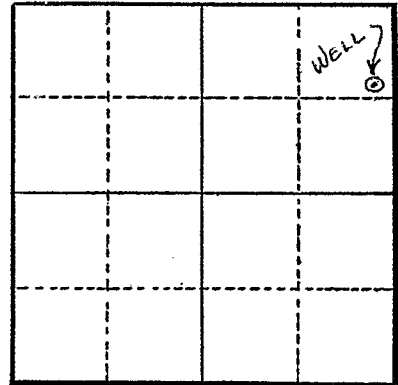

Section 34

Altitude at well

TYPE OF WELL: Drilled Date Constructed 1946

Depth drilled 96' Depth cased 96'

CASING RECORD:

6"

FINISH:

AQUIFERS:

WATER LEVEL:

19'

PUMPING EQUIPMENT: Type Jacuzzi turbine H.P. 1 1/2

Capacity 60 G.P.M.

WELL TESTS:

Drawdown ft. after hours G.P.M.

Drawdown ft. after hours G.P.M.

USE OF WATER Irrigation Temp. °F., 19

SOURCE OF INFORMATION GR Record

DRILLER or DIGGER

ADDITIONAL DATA:

Log N.A. Water Level Measurements Chemical Analysis Aquifer Test

REMARKS:

Materials consist mostly of clay, (sand, black)

Irrigation of 6 acres