

STATE ENGINEER
Salem, Oregon

4736
MAR 36

Well Record

STATE WELL NO. 6/2W-34C
COUNTY Marion
APPLICATION NO. GR-1298

GR- 1255

OWNER: Harry J. Zedern

MAILING ADDRESS:

LOCATION OF WELL: Owner's No.


CITY AND STATE:

Salem, Oregon

NE 1/4 NW 1/4 Sec. 34 T. 6 S., R. 2 W., W.M.

Bearing and distance from section or subdivision

corner 2100' E. & 100' S. from NW cor. Sec. 34

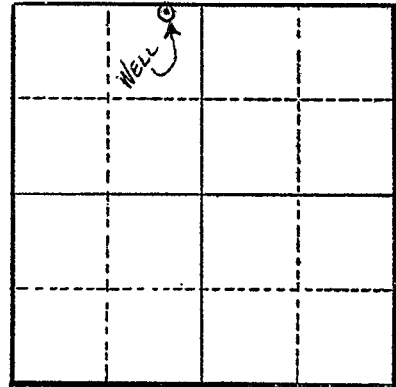

Section 34

Altitude at well 180 ft.

TYPE OF WELL: Drilled Date Constructed 1955

Depth drilled 110 ft. Depth cased 110 ft.

CASING RECORD:

8 inch

FINISH:

Perforated: 256 Mills from 80 to 110 ft.

AQUIFERS:

WATER LEVEL:

28 ft.

PUMPING EQUIPMENT: Type F. M. turbine H.P. 7 1/2

Capacity 125 G.P.M.

WELL TESTS:

Drawdown 51 ft. after 250 hours G.P.M.

Drawdown 16 ft. after 100 hours G.P.M.

USE OF WATER Irrigation Temp. °F., 19

SOURCE OF INFORMATION G. R. Record

DRILLER or DIGGER Willamette Drilling Co.

ADDITIONAL DATA:

Log Water Level Measurements Chemical Analysis Aquifer Test

REMARKS:

Log:	Yellow clay & silt	0 to 77 ft.
	Sand & gravel (water)	77 to 89 ft.
	Cement gravel	89 to 94 ft.
	Sand & gravel (water)	94 to 96 ft.
	Cement gravel	96 to 100 ft.
	Shale & gravel	100 to 108 ft.
	Brown sand & gravel (water)	108 to 110 ft.
	Cement gravel (tight)	110 to ?

Irrigation of 16 acres.