

STATE ENGINEER
Salem, Oregon

4748
MARION

Well Record

STATE WELL NO. 6/2W-35M
COUNTY Marion
APPLICATION NO. GR-3042

OWNER: Ray McKibben


MAILING ADDRESS: Route 2, Box 499

LOCATION OF WELL: Owner's No.

CITY AND STATE: Salem, Oregon

SE NW 1/4 SW 1/4 Sec. 35 T. 6 S., R. 2 W., W.M.

Bearing and distance from section or subdivision corner 1910' N. 27° 25' E. from the S.W. corner of Section 35.

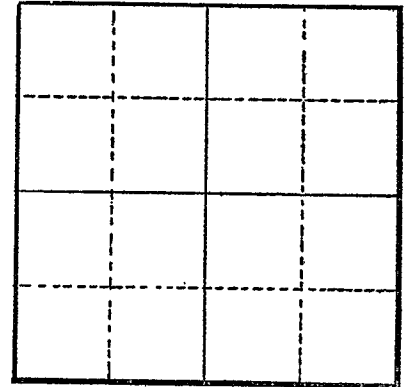

Section 111

Altitude at well

TYPE OF WELL: drilled Date Constructed 1954

Depth drilled 111 Depth cased 111

CASING RECORD:

8 inches

FINISH:

AQUIFERS:

Top soil, Clay, Mud, Sand and Gravel

WATER LEVEL:

80 feet

PUMPING EQUIPMENT: Type Jacuzzi Jet H.P. 3
Capacity 35 G.P.M.

WELL TESTS:

Drawdown unknown ft. after hours Pumping 200 G.P.M.
Drawdown ft. after hours G.P.M.

USE OF WATER Irrigation Temp. °F., 19

SOURCE OF INFORMATION GR-2848

DRILLER or DIGGER

ADDITIONAL DATA:

Log Water Level Measurements Chemical Analysis Aquifer Test

REMARKS:

Top soil	3	111
Brown clay	17	
Clay mud	75	
Sand	10	
Loose gravel	6	