

STATE ENGINEER
Salem, Oregon

MAR 4 1954
Well Record

STATE WELL NO. 6/2W-35 Q
COUNTY Marion
APPLICATION NO. GR-859

OWNER: Donald D. Kuenzi


MAILING ADDRESS: Route 2, Box 537

LOCATION OF WELL: Owner's No.

CITY AND STATE: Salem

SW 1/4 SE 1/4 Sec. 35 T. 6 N. S. R. 2 W., W.M.

Bearing and distance from section or subdivision corner 2640' W & 17' N Sec. 35

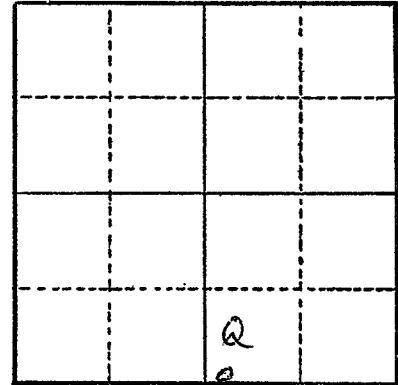

Section 35

Altitude at well 195'

TYPE OF WELL: Drilled Date Constructed June, 1954

Depth drilled 147 Depth cased 147

CASING RECORD:

10-inch 0 to 147 feet

FINISH:

10-inch perforations per foot - 1/4" x 3"

AQUIFERS:

WATER LEVEL:

25

PUMPING EQUIPMENT: Type Jacuzzi Turbine H.P. 40 Elec.
Capacity 600 G.P.M.

WELL TESTS:

Drawdown 65' ft. after 600 hours G.P.M.
Drawdown ft. after hours G.P.M.

USE OF WATER Irrigation Temp. °F., 19

SOURCE OF INFORMATION Registration Statement GR-832

DRILLER or DIGGER Rudolph Stadeli - Route 2, Silverton, Oregon

ADDITIONAL DATA:

Log X Water Level Measurements Chemical Analysis Aquifer Test

REMARKS:

