

STATE ENGINEER
Salem, Oregon

4750
MARI.....

Well Record

STATE WELL NO. 6/ZW-35R
COUNTY MARION
APPLICATION NO. GR-2579

OWNER: Paul Jensen


MAILING ADDRESS: Rt. 2, Box 195

LOCATION OF WELL: Owner's No. #1

CITY AND STATE: Silverton, Oregon

SE 1/4 SE 1/4 Sec. 35 T. 6 S., R. 2 W., W.M.

Bearing and distance from section or subdivision corner S. 81° 30' E. 424' thence S. 11° 10' W. 227.6'

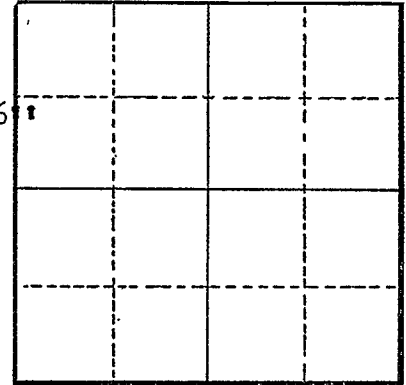

Section

Altitude at well

TYPE OF WELL: Drilled Date Constructed 1952

Depth drilled 155 Depth cased 155

CASING RECORD:

10-inch

FINISH:

4 to 5 every 2' 3/8" by 3" from 90' to 154'

AQUIFERS:

Topsoil, loam, clay, sand and gravel

WATER LEVEL:

45-feet

PUMPING EQUIPMENT: Type Jacuzzi Turbine H.P. 30
Capacity 476 G.P.M.

WELL TESTS:

Drawdown 145 ft. after hours Pumping 500 G.P.M.
Drawdown 120 ft. after hours G.P.M.

USE OF WATER Irrigation Temp. °F., 19

SOURCE OF INFORMATION GR-2449

DRILLER or DIGGER R. Stadler

ADDITIONAL DATA:

Log Water Level Measurements Chemical Analysis Aquifer Test

REMARKS:

Topsoil	Brown	4	4
Loam	Brown	26	30
Clay	Blue	20	50
Sandy clay	Blue	25	75
Sandy clay	Brown	5	80
Sand	Redish Brown	5	85
Cement gravel and water bearing sand and gravel	grey	65	155