

STATE ENGINEER
Salem, Oregon

4761
MARI...

Well Record

STATE WELL NO. 6/2W-35 G (1)
COUNTY Marion
APPLICATION NO. GR-338

OWNER: Edward and Lillian Hynes


MAILING ADDRESS: Route 2, Box 492

LOCATION OF WELL: Owner's No. 1

CITY AND STATE: Salem, Oregon

SW 1/4 NE 1/4 Sec. 35 T. 6 S., R. 2 W., W.M.

Bearing and distance from section or subdivision corner 30 chains West and 45 chains South from NE corner Sec. 35

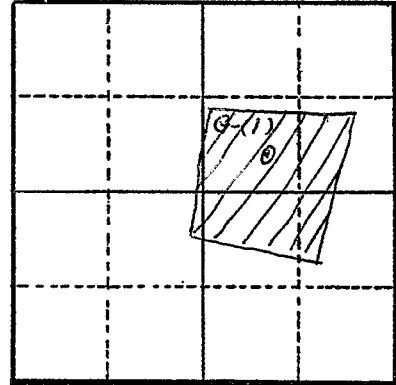

Section 35

Altitude at well 185 feet Interpolated

TYPE OF WELL: Drilled Date Constructed 5/7/55

Depth drilled 147 Depth cased 147

CASING RECORD:

10-inch casing set from 0 to 147 feet

FINISH:

perforated from 95 to 147 feet

AQUIFERS:

gravels from 85 to 107 feet and 132 to 147 feet

WATER LEVEL:

PUMPING EQUIPMENT: Type Jacuzzi-Turbine H.P. 30
Capacity 350 G.P.M.

WELL TESTS:

Drawdown	64	ft. after	hours	Pumping	300	5/26/55	G.P.M.
Water level	66			"	400		
Drawdown	71	ft. after	hours	"	450		G.P.M.

USE OF WATER Irrigation-80 acres Temp. °F., 19

SOURCE OF INFORMATION Registration Statement GR-323

DRILLER or DIGGER R. Stadeli & Sons; Silverton, Oregon

ADDITIONAL DATA:

Log Yes Water Level Measurements Chemical Analysis Aquifer Test

REMARKS:

