

STATE ENGINEER  
Salem, Oregon

# Well Record


STATE WELL NO. 6/3W-2A(1)  
COUNTY Marion  
APPLICATION NO. GR-874

4790  
MARI.....

OWNER: Joe Ryan MAILING ADDRESS: Route 1, Box 104

LOCATION OF WELL: Owner's No. CITY AND STATE: Gervais, Oregon

NE  $\frac{1}{4}$  NE  $\frac{1}{4}$  Sec. 2 T. 6 S., R. 3 W., W.M.  
Bearing and distance from section or subdivision corner 500 feet West and 120 feet South from the SE Corner, Section 35.

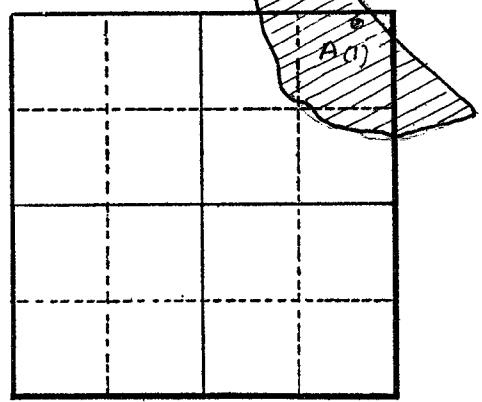

Section 2

Altitude at well \_\_\_\_\_

TYPE OF WELL: Drilled Date Constructed Aug. 1947

Depth drilled 43 feet Depth cased 43 feet

### CASING RECORD:

10-inch diameter casing set from 0 to 43 feet

### FINISH:

Perforated 33 to 43 feet  $\frac{1}{2}$ " x 5"  
5 perforations per foot

### AQUIFERS:

33-43 feet heavy gravel waterbearing

### WATER LEVEL:

22 feet

PUMPING EQUIPMENT: Type 4" Fairbanks Morse H.P. \_\_\_\_\_  
Capacity 450 G.P.M. International U-4 Gas Motor ←

### WELL TESTS:

Drawdown 2 ft. after \_\_\_\_\_ hours 400 G.P.M.  
Drawdown \_\_\_\_\_ ft. after \_\_\_\_\_ hours \_\_\_\_\_ G.P.M.

USE OF WATER Irrigation Temp. \_\_\_\_\_ °F., 19\_\_\_\_

SOURCE OF INFORMATION XXXXX GR - 847

### DRILLER or DIGGER

### ADDITIONAL DATA:

Log X Water Level Measurements \_\_\_\_\_ Chemical Analysis \_\_\_\_\_ Aquifer Test \_\_\_\_\_

### REMARKS:

