

STATE ENGINEER
Salem, Oregon


4794
MARI...

Well Record

STATE WELL NO. 6/3W-2L
COUNTY Marion
APPLICATION NO. GR-2262

OWNER: Ruel Bradford
MAILING ADDRESS: Route 1, Box 86
CITY AND STATE: Gervais, Oregon

LOCATION OF WELL: Owner's No. _____
NE 1/4 SW 1/4 Sec. 2 T. 6 N. S. R. 3 E. W.M.
Bearing and distance from section or subdivision
corner North 50° 30' East 1362 feet from the
NW Corner Allanson Beers DLC 38

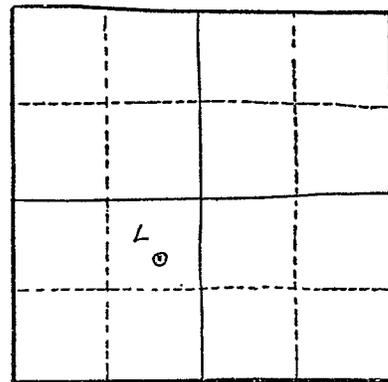

Section 2

Altitude at well _____
TYPE OF WELL: Drilled Date Constructed 1950
Depth drilled 41 feet Depth cased 41 feet

CASING RECORD:

6-inch

FINISH:

Perforations from 34 to 40 feet

AQUIFERS:

Sand and gravel from 24 to 41 feet

WATER LEVEL:

22 feet below land surface

PUMPING EQUIPMENT: Type Jet H.P. 1 1/2
Capacity 15 G.P.M.

WELL TESTS:

Drawdown 2 ft. after _____ hours Pumping 40 G.P.M.
Drawdown _____ ft. after _____ hours _____ G.P.M.

USE OF WATER Irrigation Temp. °F. 19
SOURCE OF INFORMATION GR-2262 GR. - 2159
DRILLER or DIGGER Emil Beier

ADDITIONAL DATA:

Log Water Level Measurements _____ Chemical Analysis _____ Aquifer Test _____

REMARKS:

soil 0 to 2 feet
clay, yellow 2 to 24 feet
sand and gravel 24 to 41 feet

