

STATE ENGINEER  
Salem, Oregon

4799  
MARI...

# Well Record

STATE WELL NO. 6/3W-2N  
COUNTY Marion  
APPLICATION NO. Gr-951

OWNER: Paul Townsend


MAILING ADDRESS: Rt. 1

LOCATION OF WELL: Owner's No.

CITY AND STATE: Gervais, Oregon

SW 1/4 SW 1/4 Sec. 2 T. 6 S., R. 2 W., W.M.

Bearing and distance from section or subdivision corner 5000' W. & 425' N. from SE cor. of sec. 2.

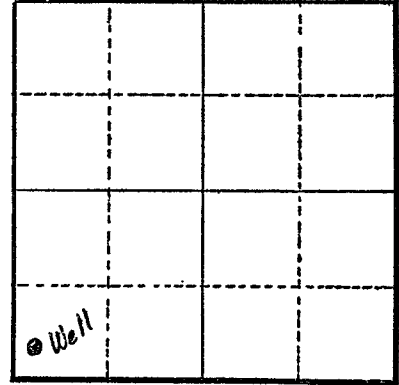

Altitude at well 117 ft.

TYPE OF WELL: Drilled Date Constructed 1949

Depth drilled 63 ft. Depth cased

Section 2

### CASING RECORD:

10 inch

### FINISH:

### AQUIFERS:

### WATER LEVEL:

20 ft. (9- -49)

PUMPING EQUIPMENT: Type Cook turbine H.P. 40  
Capacity 300 G.P.M.

### WELL TESTS:

Drawdown 15 ft. after 900 hours G.P.M.  
Drawdown ft. after hours G.P.M.

USE OF WATER Irrigation Temp. °F. 19

SOURCE OF INFORMATION G.R. Record

DRILLER or DIGGER J. A. Sneed & Son

### ADDITIONAL DATA:

Log Water Level Measurements Chemical Analysis Aquifer Test

### REMARKS:

Irrigation of 70 acres.