

STATE ENGINEER
Salem, Oregon

MARION 4800

Well Record

STATE WELL NO. 6/3W-2-P
COUNTY Marion
APPLICATION NO. GR-3327

OWNER: Frank Burke (J.) MAILING ADDRESS: Route 1, Box 85

LOCATION OF WELL: Owner's No. CITY AND STATE: Gervais, Oregon

SE 1/4 SW 1/4 Sec. 2 T. 6 N. S., R. 3 W., W.M.


Bearing and distance from section or subdivision corner S. 34°32' E. 1754.9' thence N. 56°54' E 653.5' from most Westerly corner of Alanson Beers

DLC 38

Altitude at well

TYPE OF WELL: drilled Date Constructed 1952

Depth drilled 55' Depth cased 55'

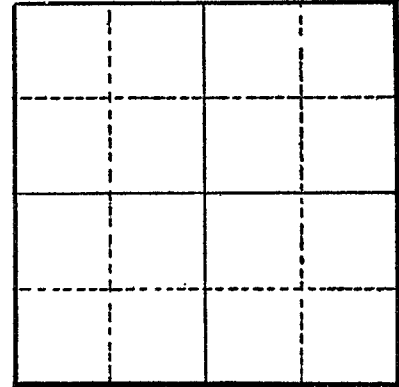

Section

CASING RECORD:

8"

FINISH:

360 perforations from 30 to 53'

AQUIFERS:

clay, sand, gravel

WATER LEVEL:

20'

PUMPING EQUIPMENT: Type Pomona Turbine H.P. 5
Capacity 100 G.P.M.

WELL TESTS:

Drawdown ft. after hours G.P.M.

Drawdown ft. after hours G.P.M.

USE OF WATER Irrigation Temp. °F. 19

SOURCE OF INFORMATION GR-3084

DRILLER or DIGGER

ADDITIONAL DATA:

Log Water Level Measurements Chemical Analysis Aquifer Test

REMARKS:

