

STATE ENGINEER
Salem, Oregon

4801
MARION

Well Record

STATE WELL NO. 6/3W-2P(1)
COUNTY Marion
APPLICATION NO.

OWNER: F. J. Burke


MAILING ADDRESS:

LOCATION OF WELL: Owner's No.

CITY AND STATE:

1/4 1/4 Sec. T. N. S, R. E. W., W.M.

Bearing and distance from section or subdivision corner

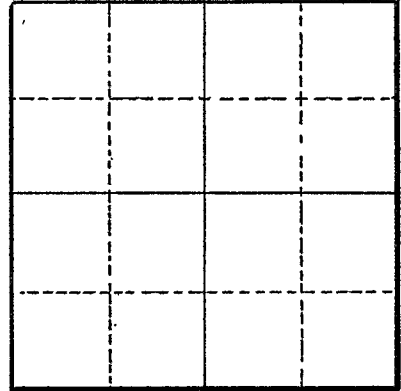

Section

Altitude at well 116

TYPE OF WELL: Drilled Date Constructed 1952

Depth drilled 55 Depth cased 55

CASING RECORD:

8 inch

FINISH:

Casing perforated 30 to 53

AQUIFERS:

Gravel from 29 to 55

WATER LEVEL:

20 feet below land surface, August, 1952

PUMPING EQUIPMENT: Type Turbine H.P. 5
Capacity G.P.M.

WELL TESTS:

Drawdown ft. after hours G.P.M.
Drawdown ft. after hours G.P.M.

USE OF WATER Irrigation 12 acres Temp. °F. 19

SOURCE OF INFORMATION USGS

DRILLER or DIGGER

ADDITIONAL DATA:

Log X Water Level Measurements Chemical Analysis Aquifer Test

REMARKS:

