

STATE ENGINEER  
Salem, Oregon

4814  
MAR 1947

# Well Record

STATE WELL NO. 6/3W-3K(1)  
COUNTY Marion  
APPLICATION NO. GR-459

OWNER: Fred Viesko


MAILING ADDRESS: Route 1, Box 105

LOCATION OF WELL: Owner's No. #2

CITY AND STATE: Gervais, Oregon

NW 1/4 SE 1/4 Sec. 3 T. 6 S. R. 3 W., W.M.

Bearing and distance from section or subdivision corner South 35° 0' West 76 feet from angle corner in South line of W. Metheny DLO

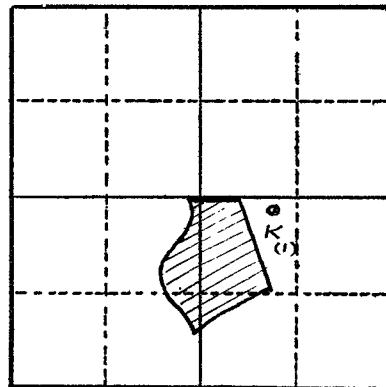

Section 3

Altitude at well 105±

TYPE OF WELL: Drilled Date Constructed May 15, 1947

Depth drilled 40± Depth cased 40±

### CASING RECORD:

10 inch

### FINISH:

### AQUIFERS:

gravel from 35 to 40

### WATER LEVEL:

15±

PUMPING EQUIPMENT: Type Centrifugal H.P. 40  
Capacity 600 G.P.M.

### WELL TESTS:

Drawdown ..... ft. after ..... hours ..... G.P.M.  
Drawdown ..... ft. after ..... hours ..... G.P.M.

USE OF WATER Irrigation 39.4 Temp. °F. 19

SOURCE OF INFORMATION GR-459 443

DRILLER or DIGGER

### ADDITIONAL DATA:

Log  Water Level Measurements ..... Chemical Analysis ..... Aquifer Test .....

### REMARKS:

sandy loam 0 to 10 feet  
sand and gravel 10 to 35 feet  
gravel 35 to 40 feet