

STATE ENGINEER
Salem, Oregon

7815
MARI...

Well Record

STATE WELL NO. 6/3W-3P(1)
COUNTY Marion
APPLICATION NO. GR-459

OWNER: Fred Viesko

MAILING ADDRESS: Route 1, Box 105


LOCATION OF WELL: Owner's No. # 1

CITY AND STATE: Gervais, Oregon

SE 1/4 SW 1/4 Sec. 3 T. 6 S. R. 3 W., W.M.

Bearing and distance from section or subdivision

corner South 45° 20' West 2084.8 feet from angle point in South line
in W. Matheny DIC

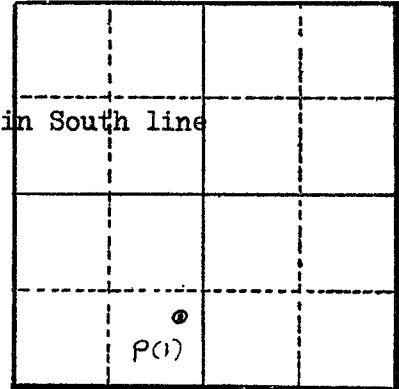

Altitude at well 105±

TYPE OF WELL: Drilled Date Constructed Apr. 15, 1948

Depth drilled 40± Depth cased

Section 3

CASING RECORD:

10-inch

FINISH:

AQUIFERS:

gravel from 30 to 40 feet

WATER LEVEL:

12 feet

PUMPING EQUIPMENT: Type Centrifugal H.P. 40
Capacity 600 G.P.M.

WELL TESTS:

Drawdown ft. after hours G.P.M.

Drawdown ft. after hours G.P.M.

USE OF WATER Irrigation 37.6 Temp. °F. 19

SOURCE OF INFORMATION GR-459 443

DRILLER or DIGGER

ADDITIONAL DATA:

Log Water Level Measurements Chemical Analysis Aquifer Test

REMARKS:

sandy loam 0 to 10 feet
sand and gravel 10 to 30 feet
gravel 30 to 40 feet