

STATE ENGINEER
Salem, Oregon

MARION
4825

Well Record

GR- 1565

STATE WELL NO. 6/3W-9G(1)
COUNTY Marion
APPLICATION NO. GR- 1488

OWNER: Jessie E. Moudy

MAILING
ADDRESS:


LOCATION OF WELL: Owner's No.

CITY AND
STATE:

Whittier, California

SW 1/4 NE 1/4 Sec. 9 T. 6 S., R. 3 W., W.M.

Bearing and distance from section or subdivision
corner 100' N. & 380' W. of SE cor. of SW 1/4 NE 1/4
of Section 9

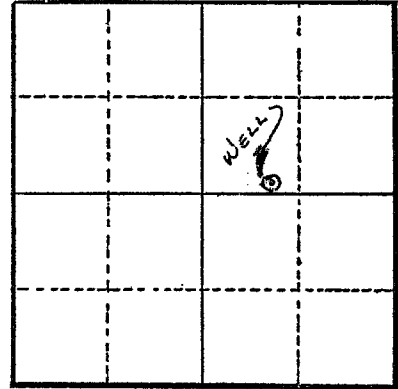

Section 9

Altitude at well

112'

TYPE OF WELL: Drilled Date Constructed 1954

Depth drilled 85' Depth cased 85'

CASING RECORD:

10"

FINISH:

AQUIFERS:

WATER LEVEL:

23' (10 - - 54)

PUMPING EQUIPMENT: Type Turbine

H.P. 40

Capacity 500 G.P.M.

WELL TESTS:

Drawdown _____ ft. after _____ hours _____ G.P.M.

Drawdown _____ ft. after _____ hours _____ G.P.M.

USE OF WATER Irrigation Temp. _____ °F. _____, 19

SOURCE OF INFORMATION GR Record

DRILLER or DIGGER Studebaker Bros.

ADDITIONAL DATA:

Log N.A. Water Level Measurements _____ Chemical Analysis _____ Aquifer Test _____

REMARKS:

Irrigation of 57 acres.