

STATE ENGINEER  
Salem, Oregon

4826  
MARI.....

# Well Record

STATE WELL NO. 6/3W-9J  
COUNTY MARION  
APPLICATION NO. GR-2794

OWNER: T. R. Girod


MAILING ADDRESS: 7115 Wheatland Rd.

LOCATION OF WELL: Owner's No.

CITY AND STATE: Salem, Oregon

NE 1/4 SE 1/4 Sec. 9 T. 6 N. S. R. 3 E. W., W.M.

Bearing and distance from section or subdivision corner 351' N. and 107' W.

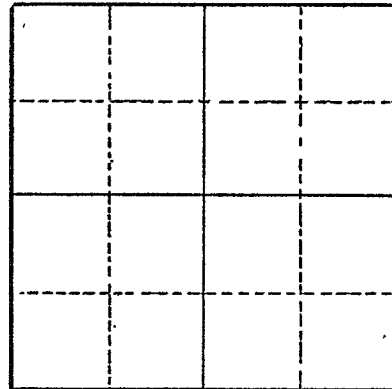

Section

Altitude at well

TYPE OF WELL: drilled Date Constructed 1955

Depth drilled 39 Depth cased 39

### CASING RECORD:

12-inch

### FINISH:

16 mills from 29 to 39

### AQUIFERS:

Topsoil, clay and gravel

### WATER LEVEL:

12-14-feet

PUMPING EQUIPMENT: Type Cornell Centrifugal H.P. 30  
Capacity 700 G.P.M.

### WELL TESTS:

Drawdown 3 ft. after hours Pumping 700 G.P.M.  
Drawdown ft. after hours G.P.M.

USE OF WATER irrigation Temp. °F., 19

SOURCE OF INFORMATION GR-2639

DRILLER or DIGGER Harry Robinson

### ADDITIONAL DATA:

Log  Water Level Measurements Chemical Analysis Aquifer Test

### REMARKS:

Topsoil 4 35  
Clay 23 12  
Gravel 12 0