

STATE ENGINEER  
Salem, Oregon

4837  
MARION

# Well Record

STATE WELL NO. 6/3W-10Q  
COUNTY Marion  
APPLICATION NO. CR-3039

OWNER: George J. Landrith


MAILING ADDRESS: Route 2, Box 121

LOCATION OF WELL: Owner's No. 3

CITY AND STATE: Salem, Oregon

SW  $\frac{1}{4}$  SE  $\frac{1}{4}$  Sec. 10 T. 6 N. S., R. 3 W. W.M.

Bearing and distance from section or subdivision corner 1050' E. and 850' N. of S.W. corner of SW $\frac{1}{4}$  SE $\frac{1}{4}$

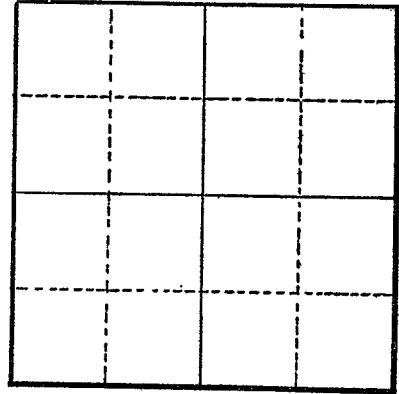

Section \_\_\_\_\_

Altitude at well \_\_\_\_\_

TYPE OF WELL: drilled Date Constructed 1955

Depth drilled 80 Depth cased 80

### CASING RECORD:

12 inches

### FINISH:

8 perforations 3/8 by 2 1/4 from 70 to 75  
8 perforations 3/8 by 2 1/4 from 75 to 80

### AQUIFERS:

Soil, clay and gravel

### WATER LEVEL:

12 feet

PUMPING EQUIPMENT: Type Berekeley turbine H.P. 25  
Capacity 650 G.P.M.

### WELL TESTS:

Drawdown 65 ft. after \_\_\_\_\_ hours Pumping 650 G.P.M.  
Drawdown \_\_\_\_\_ ft. after \_\_\_\_\_ hours \_\_\_\_\_ G.P.M.

USE OF WATER Irrigation Temp. \_\_\_\_\_ °F. \_\_\_\_\_, 19\_\_\_\_

SOURCE OF INFORMATION CR-2845

DRILLER or DIGGER \_\_\_\_\_

### ADDITIONAL DATA:

Log  Water Level Measurements \_\_\_\_\_ Chemical Analysis \_\_\_\_\_ Aquifer Test \_\_\_\_\_

### REMARKS:

Top soil	6	6
Sub soil "clay"	24	30
Sandy clay	14	44
Sticky clay "dark color"	18	62
Sandy gravel	18	80