

STATE ENGINEER
Salem, Oregon

Well Record

STATE WELL NO. 6/3W-102(1)
COUNTY Marion
APPLICATION NO.

OWNER: George Landrith

MAILING
ADDRESS:

LOCATION OF WELL: Owner's No.

CITY AND
STATE:

1/4 1/4 Sec. T. N. E.
S. R. W., W.M.


Bearing and distance from section or subdivision

corner

Altitude at well 110

TYPE OF WELL: Drilled Date Constructed 1955

Depth drilled 80 Depth cased 80

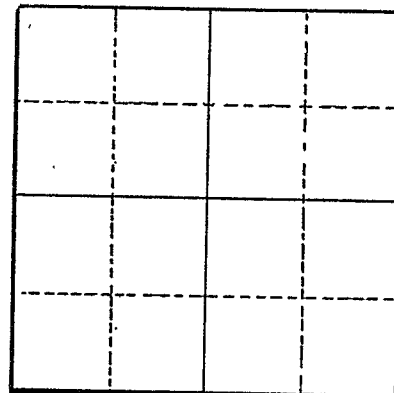

Section

CASING RECORD:

12 inch

FINISH:

Casing perforated 70 to 80

AQUIFERS:

Gravel from 62 to 80

WATER LEVEL:

12 feet below land surface, June, 1955

PUMPING EQUIPMENT: Type Turbine H.P. 25
Capacity G.P.M.

WELL TESTS:

Drawdown ft. after hours G.P.M.
Drawdown ft. after hours G.P.M.

USE OF WATER Irrigation Temp. °F. 19

SOURCE OF INFORMATION USGS

DRILLER or DIGGER

ADDITIONAL DATA:

Log Water Level Measurements Chemical Analysis Aquifer Test

REMARKS: