

STATE ENGINEER  
Salem, Oregon

4848  
MAR. 11. 58 Well Record


STATE WELL NO. 6/3W-11B(1)  
COUNTY Marion  
APPLICATION NO. GR-533

OWNER: Frank Toney MAILING ADDRESS: 1355 Harmony Drive

LOCATION OF WELL: Owner's No. CITY AND STATE: Salem, Oregon

NW  $\frac{1}{4}$  NE  $\frac{1}{4}$  Sec. 11 T. 6 <sup>N.</sup> S., R. 3 <sup>E.</sup> W., W.M.

Bearing and distance from section or subdivision corner 450 feet East and 520 feet South from  
N $\frac{1}{4}$  Corner, Section 11

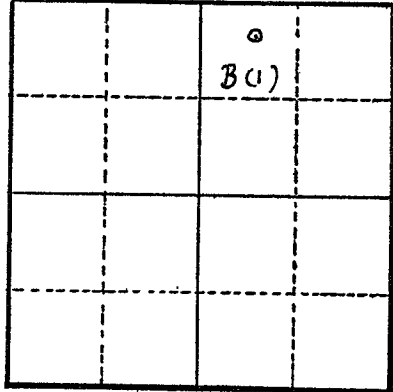

Section 11

Altitude at well 113 feet

TYPE OF WELL: Drilled Date Constructed June 1954

Depth drilled 40 feet Depth cased 40 feet

CASING RECORD:

6-inch

FINISH:

AQUIFERS:

WATER LEVEL:

20 feet

PUMPING EQUIPMENT: Type Jet H.P. 3  
Capacity 30 G.P.M.

WELL TESTS:

Drawdown \_\_\_\_\_ ft. after \_\_\_\_\_ hours \_\_\_\_\_ G.P.M.  
Drawdown \_\_\_\_\_ ft. after \_\_\_\_\_ hours \_\_\_\_\_ G.P.M.

USE OF WATER Irrigation 3.0 Temp. \_\_\_\_\_ °F. \_\_\_\_\_, 19\_\_\_\_

SOURCE OF INFORMATION GR-~~533~~ 510

DRILLER or DIGGER Jim Byers

ADDITIONAL DATA:

Log (NA) Water Level Measurements \_\_\_\_\_ Chemical Analysis \_\_\_\_\_ Aquifer Test \_\_\_\_\_

REMARKS: