

STATE ENGINEER
Salem, Oregon

4852
MARI.....

Well Record

STATE WELL NO. 6/3W-11M(1)
COUNTY Marion
APPLICATION NO. GR-718

OWNER: Jack Robert Chapin

MAILING ADDRESS:

Route 2, Box 206


LOCATION OF WELL: Owner's No. 2

CITY AND STATE:

Salem, Oregon

SW 1/4 NE 1/4 Sec. 11 T. 6 N. S. R. 3 E. W., W.M.

Bearing and distance from section or subdivision corner
1319 feet East 1920 feet North from SE Corner, Section 11

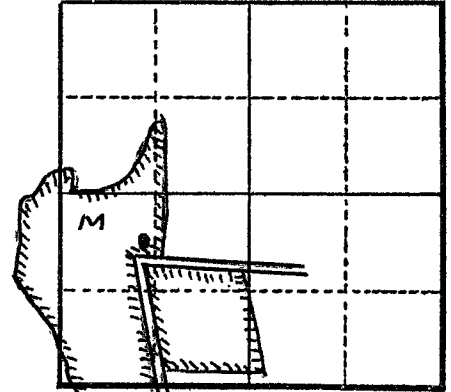

Altitude at well 115 feet interpolated

TYPE OF WELL: Drilled Date Constructed 1930

Depth drilled 55 Depth cased 55

CASING RECORD:

8 inch

FINISH:

AQUIFERS:

WATER LEVEL:

6 feet 4.5 (3-11-60)

PUMPING EQUIPMENT: Type Centrifugal H.P. 20
Capacity 700 G.P.M.

WELL TESTS: 2
Drawdown ft. after hours 550 G.P.M.
Drawdown ft. after hours G.P.M.

USE OF WATER Irrigation 165 Temp. °F. 19

SOURCE OF INFORMATION GR-668

DRILLER or DIGGER

ADDITIONAL DATA:

Log - Water Level Measurements Chemical Analysis Aquifer Test

REMARKS:

Also used for small duck pond