

STATE ENGINEER  
Salem, Oregon

4853  
MARION

# Well Record

STATE WELL NO. 6/3W-11N(1)  
COUNTY Marion  
APPLICATION NO. GR-717

OWNER: Jack Robert Chapin

MAILING

ADDRESS: Route 2, Box 206


LOCATION OF WELL: Owner's No. 1

CITY AND

STATE: Salem, Oregon

SW 1/4 SW 1/4 Sec. 11 T. 6 N. S. R. 3 E. W., W.M.

Bearing and distance from section or subdivision  
corner 990 feet East and 990 feet North from  
SE Corner, Section 11

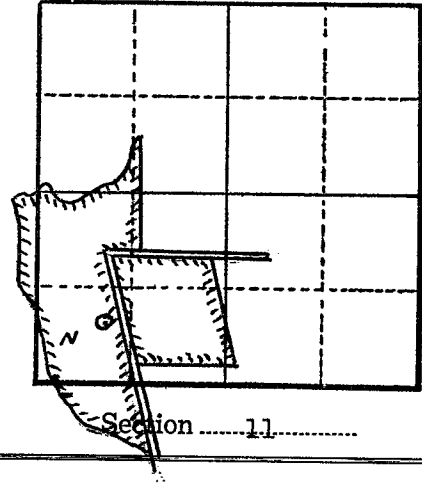

Altitude at well 115 feet interpolated

TYPE OF WELL: Drilled Date Constructed 1930

Depth drilled 75 feet Depth cased

CASING RECORD:

8-inch

FINISH:

AQUIFERS:

WATER LEVEL:

10 feet

PUMPING EQUIPMENT: Type Pacific Centrifugal H.P. 30  
Capacity ? G.P.M.

WELL TESTS:

Drawdown ft. after hours G.P.M.  
Drawdown ft. after hours G.P.M.

USE OF WATER Irrigation 145 Temp. °F. 19

SOURCE OF INFORMATION GR-667

DRILLER or DIGGER

ADDITIONAL DATA:

Log Water Level Measurements Chemical Analysis Aquifer Test

REMARKS: