

STATE ENGINEER
Salem, Oregon

4854
MARI.....

Well Record

STATE WELL NO. 6/3W-11Q(1)
COUNTY Marion
APPLICATION NO. GR-460

OWNER: Fred Viesko

MAILING ADDRESS:

Route 1, Box 105

LOCATION OF WELL: Owner's No.

CITY AND STATE:


Gervais, Oregon

SW 1/4 SE 1/4 Sec. 11 T. 6 N. 3 E. S., R. W., W.M.

Bearing and distance from section or subdivision

corner 937.43 feet South and 2008.8 feet East from

NE Corner, J. Durbin DLG

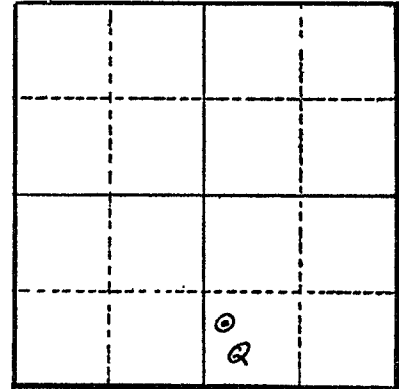

Section 11

Altitude at well 105 ±

TYPE OF WELL: Drilled Date Constructed Apr. 30, 1947

Depth drilled 40 ± Depth cased 40

CASING RECORD:

10-inch

FINISH:

AQUIFERS:

~~12~~

WATER LEVEL:

12 ±

PUMPING EQUIPMENT: Type Centrifugal H.P. 40
Capacity 600 G.P.M.

WELL TESTS:

Drawdown _____ ft. after _____ hours _____ G.P.M.

Drawdown _____ ft. after _____ hours _____ G.P.M.

USE OF WATER Irrigation 119.5 Temp. _____ °F. _____, 19

SOURCE OF INFORMATION GR-444

DRILLER or DIGGER

ADDITIONAL DATA:

Log Water Level Measurements _____ Chemical Analysis _____ Aquifer Test _____

REMARKS:

Sandy loam	0	to	8 feet
Sand & gravel	8	to	28 feet
Gravel	28	to	40 feet