

STATE ENGINEER
Salem, Oregon

MAR. 28 1960

Well Record


STATE WELL NO. 6/3W-12N(1)
COUNTY Marion
APPLICATION NO. GR-670

OWNER: Robert L. Reed
MAILING ADDRESS: Route 2, Box 159

LOCATION OF WELL: Owner's No. 1
CITY AND STATE: Salem, Oregon

SW 1/4 SW 1/4 Sec. 12 T. 6 N. S., R. 3 E. W., W.M.

Bearing and distance from section or subdivision
corner 1320 feet East and 660 feet North from
the SW Corner, Section 12

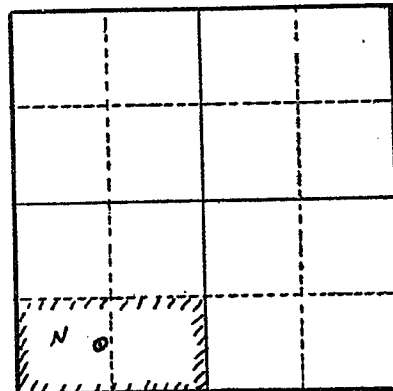

Section 12

Altitude at well 130 feet interpolated

TYPE OF WELL: Drilled Date Constructed May 1947

Depth drilled 21 feet Depth cased 21 feet

CASING RECORD:

9-inch

FINISH:

AQUIFERS:

WATER LEVEL:

9 feet

PUMPING EQUIPMENT: Type Centrifugal H.P. gas
Capacity 450 G.P.M.

WELL TESTS:

Drawdown 3 ft. after 750 hours G.P.M.

Drawdown ft. after hours G.P.M.

USE OF WATER Irrigation 80 Temp. °F. 19

SOURCE OF INFORMATION GR-643

DRILLER or DIGGER

ADDITIONAL DATA:

Log Water Level Measurements Chemical Analysis Aquifer Test

REMARKS: