

STATE ENGINEER
Salem, Oregon

MAR 4 1920

Well Record

STATE WELL NO. 4/1W-13B(1)
COUNTY Marion
APPLICATION NO. GR-659

OWNER: City of Aurora

MAILING
ADDRESS:

LOCATION OF WELL: Owner's No.


CITY AND
STATE:

Aurora, Oregon

NW 1/4 NE 1/4 Sec. 13 T. 4 N. S. R. 1 E. W.M.

Bearing and distance from section or subdivision

corner 524.04' S. & 154.44' E. of NW cor.
Sec. 13

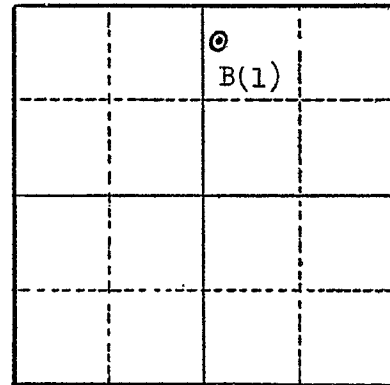

Section 13

Altitude at well 100' Interpolated

TYPE OF WELL: Drilled Date Constructed 1920

Depth drilled 190 Depth cased

CASING RECORD:

6 inch

FINISH:

AQUIFERS:

WATER LEVEL:

Flowing

PUMPING EQUIPMENT: Type Pamona Turbine H.P. 7 1/2
Capacity 250 G.P.M.

WELL TESTS:

Drawdown ft. after hours G.P.M.

Drawdown ft. after hours G.P.M.

USE OF WATER municipal Temp. °F. 19

SOURCE OF INFORMATION GR-659

DRILLER or DIGGER Peter Hornig: Canby, Oregon ?

ADDITIONAL DATA:

Log Water Level Measurements Chemical Analysis Aquifer Test

REMARKS:

Not capped