

STATE ENGINEER
Salem, Oregon

4880
MARI....

Well Record

STATE WELL NO. 6/3W-13J
COUNTY Marion
APPLICATION NO. GR-3046

OWNER: Homer Gouley


MAILING ADDRESS: Route 2, Box 217

LOCATION OF WELL: Owner's No.

CITY AND STATE: Salem, Oregon

NE 1/4 SE 1/4 Sec. 13 T. 6 N. S. R. 3 E. W., W.M.

Bearing and distance from section or subdivision corner 550' S. & 1640' W.

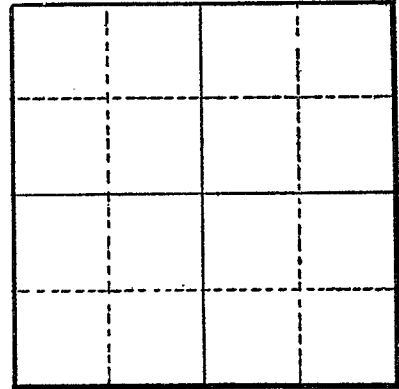

Section

Altitude at well

TYPE OF WELL: Drilled Date Constructed 1952

Depth drilled 140 ft. Depth cased 140 ft.

CASING RECORD:

10-inch

FINISH:

Perforations from 95 to 140

AQUIFERS:

Gravel

WATER LEVEL:

17 feet

PUMPING EQUIPMENT: Type Universal turbine H.P. 40
Capacity 650 G.P.M.

WELL TESTS:
Drawdown 45 ft. after hours Pumping 600 G.P.M.
Drawdown ft. after hours G.P.M.

USE OF WATER Irrigation Temp. 9F., 19

SOURCE OF INFORMATION GR-2852
DRILLER or DIGGER Fred Wymore

ADDITIONAL DATA:
Log X Water Level Measurements Chemical Analysis Aquifer Test

REMARKS:

Gravel 92 140