

STATE ENGINEER  
Salem, Oregon

4881  
MARI.....

MARI 4881

Well Record

STATE WELL NO. 6/3W-13M  
COUNTY MARION  
APPLICATION NO. GR-2888

OWNER: Bertram A. Murphy


MAILING ADDRESS: Rt. 2, Box 155

LOCATION OF WELL: Owner's No.

CITY AND STATE: Salem, Oregon

NW 1/4 SW 1/4 Sec. 13 T. 6 S., R. 3 W., W.M.

Bearing and distance from section or subdivision corner 205' W. and 1560' N.

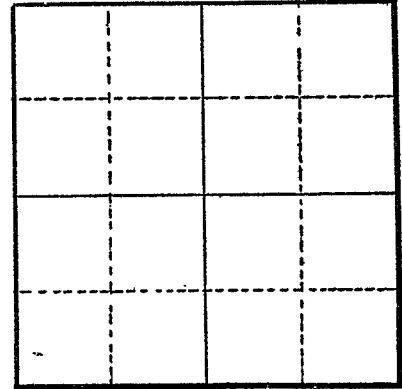

Section

Altitude at well

TYPE OF WELL: drilled Date Constructed 1947

Depth drilled 115 Depth cased 115

CASING RECORD:

6-inch

FINISH:

Slots from 97 to 112

AQUIFERS:

Topsoil, clay, sand and gravel

WATER LEVEL:

50-feet

PUMPING EQUIPMENT: Type Jacuzzi Jet H.P. 2  
Capacity 30 G.P.M.

WELL TESTS:

Drawdown ft. after hours G.P.M.  
Drawdown ft. after hours G.P.M.

USE OF WATER irrigation Temp. °F. 19

SOURCE OF INFORMATION GR-2717

DRILLER or DIGGER Chuck Church with Harvey Evans, Clearlake, Oregon Route 2

ADDITIONAL DATA:

Log X Water Level Measurements Chemical Analysis Aquifer Test

REMARKS:

Topsoil 3  
Clay sub- 30  
Blue clay sand 54  
Sand 10  
Gravel 18



Oregon Water Resources Department
725 Summer Street NE, Suite A
Salem Oregon 97301
(503) 986-0900
www.wrd.state.or.us

Application for
Well ID Number

RECEIVED

MAY 05 2016

WATER RESOURCES DEPT
SALEM, OREGON

Do not complete if the well already has a Well Identification Number.

I. OWNER INFORMATION

Current Owner Name (please print): Michael & Fume Schoadt
Mailing Address: 8740 Wheatland Rd
City, State, Zip: Kelzer, Oregon
Mail Well ID Tag to: [ ] SAME AS ABOVE [x] In Care Of (C/O)
Name & Address: Ronald Schoadt Picked Up Tag in Person
City, State, Zip:

II. WELL LOCATION INFORMATION (Please fill out as completely as possible)

Township: 6 (North/South) Range: 3 (East/West) Section: 13 NW 1/4 of the SW 1/4
Tax Lot (usually last 3-5 numbers of Tax Map #): 900 County Marion
GPS Coordinates:
Street Address of Well, City: Same

If the property had a different street address in the past:

III. GENERAL WELL INFORMATION (Please fill out as completely as possible, AND attach copy of Well Log, if available)

Use of Well (domestic, irrigation, commercial, industrial, monitoring):
Date Well Constructed (or property built): 1947 Total Well Depth: 115 Casing Diameter: 6"
Owner at time the well was constructed (if known): Bertram A. Murphy Well Log # (if known):
Other Information:

SUBMITTED BY (please print): Ronald Schoadt
PHONE: 971-218-4126 EMAIL &/or FAX:

Send application to: Oregon Water Resources Department 725 Summer St NE, Suite A, Salem, Oregon 97301; or fax to (503) 986-0902.
Applications are processed in the order they are received, and Well ID Numbers are mailed within 4-5 business days.

For Official Use Only by the Oregon Water Resources Department:

Received Date:

5-5-16

Well Log Number:

MARI 4881

Well Identification #:

L-122446