

STATE ENGINEER
Salem, Oregon

MART 489

Well Record

STATE WELL NO. 4/1W-13B(1)
COUNTY Marion
APPLICATION NO.

OWNER: City of Aurora MAILING ADDRESS:

LOCATION OF WELL: Owner's No. CITY AND STATE:

1/4 1/4 Sec. T. N. E. S., R. W., W.M.


Bearing and distance from section or subdivision

corner

Altitude at well 100

TYPE OF WELL: Drilled Date Constructed Prior 1929

Depth drilled 198 Depth cased

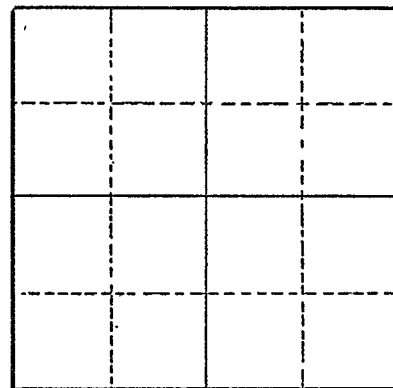

Section

CASING RECORD:

8 inch

FINISH:

AQUIFERS:

Coarse sand and gravel from 190 to 195

WATER LEVEL:

Flows

PUMPING EQUIPMENT: Type Cylinder H.P. 10
Capacity G.P.M.

WELL TESTS:

Drawdown ft. after hours G.P.M.

Drawdown ft. after hours G.P.M.

USE OF WATER Public Supply Temp. °F. 19

SOURCE OF INFORMATION USGS

DRILLER or DIGGER

ADDITIONAL DATA:

Log X Water Level Measurements Chemical Analysis Aquifer Test

REMARKS:

Well 176 in Water-Supply Paper 890.

State Well No. 4/1W-13B(1)
County Marion
Application No. _____

Owner: City of Aurora Owner's No.

Driller: _____ Date Drilled _____

[illegible]