

STATE ENGINEER
Salem, Oregon

4909
MARI...


Well Record

STATE WELL NO. 6/3W-14A(1)
COUNTY Marion
APPLICATION NO. GR-460

OWNER: Fred Viesko
MAILING ADDRESS: Route 1, Box 105
CITY AND STATE: Gervais, Oregon

LOCATION OF WELL: Owner's No. 2
NE 1/4 NE 1/4 Sec. 14 T. 6 N. S. R. 3 E. W., W.M.

Bearing and distance from section or subdivision
corner 2500.3 feet East and 3572.7 feet South from
NE Corner, J. Durbin DLC

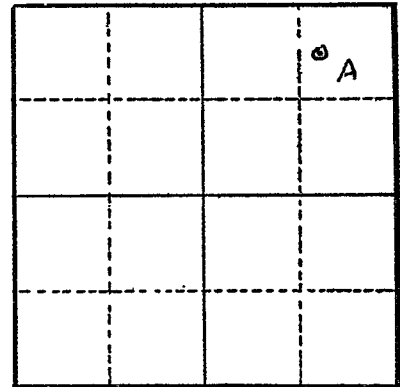

Altitude at well 105+

TYPE OF WELL: Drilled Date Constructed Apr. 30, 1947

Depth drilled 40+ Depth cased 40

Section 14

CASING RECORD:

10-inch

FINISH:

AQUIFERS:

WATER LEVEL:

15 feet 5.5 (1-14-60)

PUMPING EQUIPMENT: Type Centrifugal H.P. 40
Capacity 600 G.P.M.

WELL TESTS:

Drawdown ft. after hours G.P.M.
Drawdown ft. after hours G.P.M.

USE OF WATER Irrigation 52.5 Temp. °F., 19

SOURCE OF INFORMATION GR-444

DRILLER or DIGGER

ADDITIONAL DATA:

Log Water Level Measurements Chemical Analysis Aquifer Test

REMARKS:

Sandy loam 0 to 6 feet
Sand & gravel 6 to 26 feet
Gravel 26 to 40 feet