

STATE ENGINEER
Salem, Oregon

4910
MARI...0

Well Record

STATE WELL NO. 6/3W-14E(1)
COUNTY Marion
APPLICATION NO. GR-719


OWNER: Jack Robert Chapin
"Russell Well"

MAILING ADDRESS: Route 2, Box 206

LOCATION OF WELL: Owner's No. 3

CITY AND STATE: Salem, Oregon

SW 1/4 NW 1/4 Sec. 14 T. 6 N. S., R. 3 E. W., W.M.

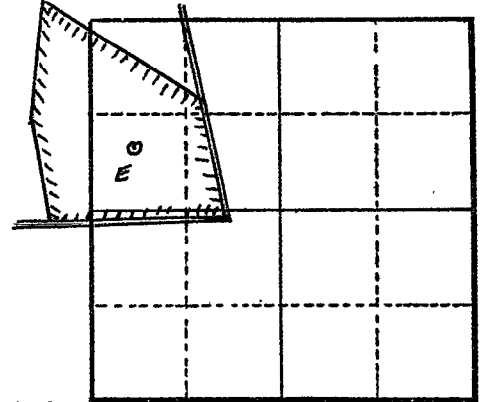

Bearing and distance from section or subdivision corner 730 feet North and 600 feet East from the W/4 Corner, Section 14, T. 6 S., R. 3 W., W. M.

Section 14

Altitude at well 115 feet interpolated

TYPE OF WELL: Drilled Date Constructed 1944

Depth drilled 25 feet Depth cased 25 feet

CASING RECORD:

12-inch 0 to 25 feet

FINISH:

Perforations from 5 to 25 feet

AQUIFERS:

sand and gravel 6 to 25 feet

WATER LEVEL:
2 feet (3-11-60)

PUMPING EQUIPMENT: Type Pacific Centrifugal H.P. 30
Capacity 650 G.P.M.

WELL TESTS:
Drawdown 5 ft. after 300 hours G.P.M.
Drawdown 18 ft. after 650 hours G.P.M.

USE OF WATER Irrigation 114.4 Temp. °F. 19

SOURCE OF INFORMATION GR-669

DRILLER or DIGGER Sloper, Independence, Oregon

ADDITIONAL DATA:

Log Water Level Measurements Chemical Analysis Aquifer Test

REMARKS:

Clay and blue sand	0	6	6
Gravel and sand (water bearing)	6	14	8
Gravel & clay (very tight)	14	21	7
Gravel & sand (water bearing)	21	25	4