

STATE ENGINEER
Salem, Oregon

49111
MARI.....

Well Record


STATE WELL NO. 6/3W-14G(1)
COUNTY Marion
APPLICATION NO. GR-460

OWNER: Fred Viesko MAILING ADDRESS: Route 1, Box 105

LOCATION OF WELL: Owner's No. 3 CITY AND STATE: Gervais, Oregon

SW 1/4 NE 1/4 Sec. 14 T. 6 N. S. R. 3 E. W., W.M.

Bearing and distance from section or subdivision corner 3349.2 feet South and 1794.4 feet East

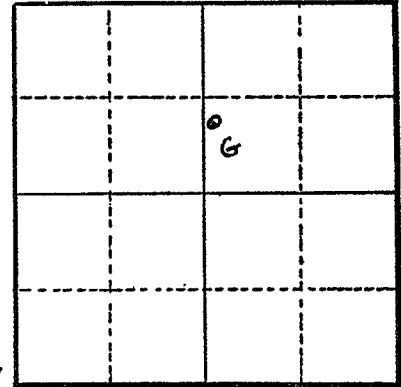

Altitude at well 105+

TYPE OF WELL: Date Constructed Apr. 30, 1947

Depth drilled 40+ Depth cased 40

Section 14

CASING RECORD:

10-inch

FINISH:

AQUIFERS:

WATER LEVEL:

15 feet

PUMPING EQUIPMENT: Type Centrifugal H.P. 40
Capacity 600 G.P.M.

WELL TESTS:

Drawdown ft. after hours G.P.M.
Drawdown ft. after hours G.P.M.

USE OF WATER Irrigation 106.7 Temp. °F. 19

SOURCE OF INFORMATION GR-444

DRILLER or DIGGER

ADDITIONAL DATA:

Log Water Level Measurements Chemical Analysis Aquifer Test

REMARKS:

Sandy loam 0 to 10 feet
Sand and gravel 10 to 35 feet
Gravel 35 to 40 feet