

STATE ENGINEER  
Salem, Oregon

49/2  
MAR 1950

# Well Record

STATE WELL NO. 6/3W-14M  
COUNTY MARION  
APPLICATION NO. GR-2430

OWNER: Arnold L. East


MAILING ADDRESS: Rt. 2, Box 14

LOCATION OF WELL: Owner's No.

CITY AND STATE: Salem, Oregon

NW 1/4 SW 1/4 Sec. 14 T. 6 S. R. 3 W. W.M.

Bearing and distance from section or subdivision corner 1700' N. and 1000' E.

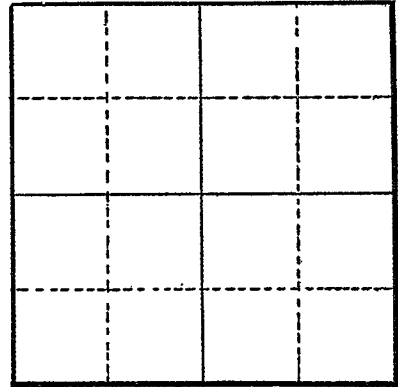

Section .....

Altitude at well

TYPE OF WELL: Drilled Date Constructed 1950

Depth drilled 50 Depth cased 50

### CASING RECORD:

6-inch

### FINISH:

### AQUIFERS:

### WATER LEVEL:

12-feet

PUMPING EQUIPMENT: Type Electric H.P. 5  
Capacity 100 G.P.M.

WELL TESTS:  
Drawdown 18 ft. after Pumping 100 G.P.M.  
Drawdown ft. after hours G.P.M.

USE OF WATER Irrigation Temp. °F. 19

SOURCE OF INFORMATION GR-2305

DRILLER or DIGGER

### ADDITIONAL DATA:

Log Water Level Measurements Chemical Analysis Aquifer Test

### REMARKS: