

STATE ENGINEER
Salem, Oregon

4932
MARI

Well Record

STATE WELL NO. 6/3W-15G
COUNTY Marion
APPLICATION NO. GR-3038

OWNER: George J. Landrith


MAILING ADDRESS: Route 2, Box 121

LOCATION OF WELL: Owner's No. 2

CITY AND STATE: Salem, Oregon

SW 1/4 NE 1/4 Sec. 15 T. 6 S., R. 3 W., W.M.

Bearing and distance from section or subdivision corner 1050' E. and 1150' N. of S.W. corner of S.W. 1/4 OF N.E. 1/4

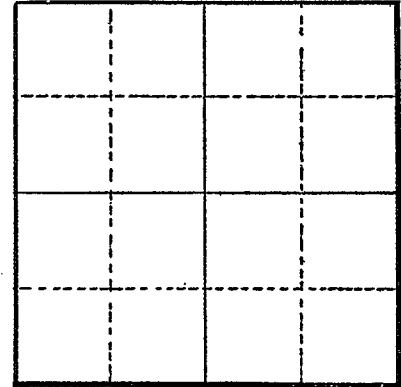

Section

Altitude at well

TYPE OF WELL: drilled Date Constructed 1954

Depth drilled 60 Depth cased 60

CASING RECORD:

12 inches

FINISH:

8 perforations 3/8 by 2 1/4 from 50 to 55
8 perforations 3/8 by 2 1/4 from 55 to 60

AQUIFERS:

Soil, clay and gravel

WATER LEVEL:

8 feet

PUMPING EQUIPMENT: Type Berkeley centrifugal H.P. 25

Capacity 650 G.P.M.

WELL TESTS:

Drawdown 22 ft. after hours Pumping 700 G.P.M.
Drawdown ft. after hours G.P.M.

USE OF WATER Irrigation Temp. °F., 19

SOURCE OF INFORMATION GR-2844

DRILLER or DIGGER

ADDITIONAL DATA:

Log Water Level Measurements Chemical Analysis Aquifer Test

REMARKS:

Top soil	4	4
Sub soil "clay"	20	24
Sandy clay	16	40
Sandy gravel	20	60