

STATE ENGINEER
Salem, Oregon

4936
MARI.....

Well Record

STATE WELL NO. 6/3W-15J(1)
COUNTY Marion
APPLICATION NO. GR-549

OWNER: Susie LaFollette & G. Barnick

MAILING ADDRESS:

Route 2, Box 127


LOCATION OF WELL: Owner's No.

CITY AND STATE:

Salem, Oregon

NE 1/4 SE 1/4 Sec. 15 T. 6 N. S., R. 3 E. W., W.M.

Bearing and distance from section or subdivision corner 1279.36 feet South and 1257.22 feet West from the SE 1/4 Corner between Section 15-14

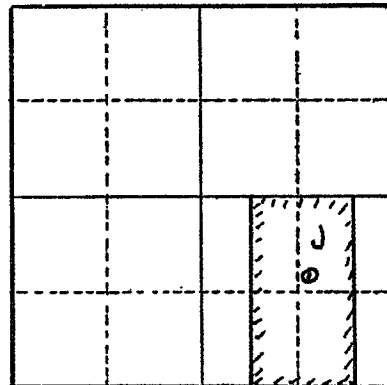

Section 15

Altitude at well 120 feet

TYPE OF WELL: Drilled Date Constructed 1944

Depth drilled 65 feet Depth cased 65 feet

CASING RECORD:

10-inch

FINISH:

AQUIFERS:

WATER LEVEL:

PUMPING EQUIPMENT: Type Turbine H.P. 20
Capacity 350 G.P.M.

WELL TESTS:

Drawdown ft. after hours G.P.M.
Drawdown ft. after hours G.P.M.

USE OF WATER Irrigation 64.7 Temp. °F. 19

SOURCE OF INFORMATION GR-524

DRILLER or DIGGER Wymore

ADDITIONAL DATA:

Log Water Level Measurements Chemical Analysis Aquifer Test

REMARKS: