

STATE ENGINEER
Salem, Oregon

9947
MAR 17

Well Record

STATE WELL NO. 6/3W-16J(2)
COUNTY Marion
APPLICATION NO. GR-150

OWNER: Ray Kerr


MAILING ADDRESS: Route 2, Box 196

LOCATION OF WELL: Owner's No. 2

CITY AND STATE: Salem, Oregon

NE 1/4 SE 1/4 Sec. 16 T. 6 N. S., R. 3 E. W., W.M.

Bearing and distance from section or subdivision corner 500 feet South and 100 feet West from the E 1/4 Corner, Section 16

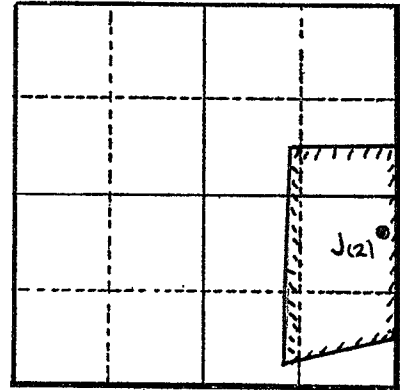

Section 16

Altitude at well 115 feet interpolated

TYPE OF WELL: Drilled Date Constructed 1954

Depth drilled 48 feet Depth cased 46 feet

CASING RECORD:

10-inch steel casing set 0 to 46 feet

FINISH:

Torch cut slots 0 to 46 feet

AQUIFERS:

no record

WATER LEVEL:

14 feet below land surface

PUMPING EQUIPMENT: Type 4 m Electric H.P. 40

Capacity 1000 G.P.M.

WELL TESTS:

Drawdown 21 ft. after hours Pumping 700 G.P.M.

Drawdown 18 ft. after hours " 500 G.P.M.

USE OF WATER Irrigation 92 Temp. °F. 19

SOURCE OF INFORMATION GR-143

DRILLER or DIGGER Sneed Bros.

ADDITIONAL DATA:

Log no Water Level Measurements Chemical Analysis Aquifer Test

REMARKS: