

STATE ENGINEER
Salem, Oregon

MAR 1961

Well Record

STATE WELL NO. 6/3W-21B(1)
COUNTY Marion
APPLICATION NO.

OWNER: H. L. Percy Nursery

MAILING ADDRESS:

LOCATION OF WELL: Owner's No.

CITY AND STATE:

..... 1/4 1/4 Sec. T. N. S., R. E. W., W.M.


Bearing and distance from section or subdivision

corner

Altitude at well 110

TYPE OF WELL: Dug Date Constructed 1938

Depth drilled 16 Depth cased

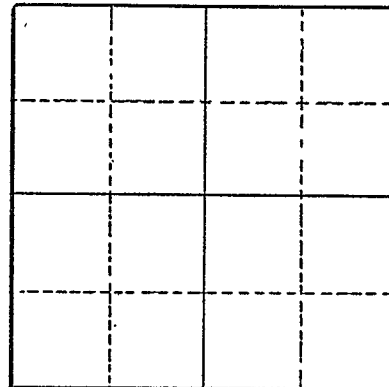

Section

CASING RECORD:

36 inch

FINISH:

Open bottom, casing unperforated

AQUIFERS:

Gravel from 6 to 16

WATER LEVEL:

PUMPING EQUIPMENT: Type Centrifugal H.P.
Capacity G.P.M.

WELL TESTS:

Drawdown ft. after hours G.P.M.

Drawdown ft. after hours G.P.M.

USE OF WATER Irrigation Temp. °F., 19

SOURCE OF INFORMATION USGS

DRILLER or DIGGER

ADDITIONAL DATA:

Log Water Level Measurements Chemical Analysis Aquifer Test

REMARKS:

Soil to 6 feet; gravel to 16 feet.