

STATE ENGINEER
Salem, Oregon

MAR 49 1962
Well Record

STATE WELL NO. 6/3W-21G(1)
COUNTY Marion
APPLICATION NO.

OWNER: H. L. Pearcy Nursery

MAILING ADDRESS:

LOCATION OF WELL: Owner's No.

CITY AND STATE:

..... 1/4 1/4 Sec. T. N. S., R. E. W., W.M.


Bearing and distance from section or subdivision

corner

Altitude at well 121

TYPE OF WELL: Drilled Date Constructed 1948

Depth drilled 48 Depth cased 48

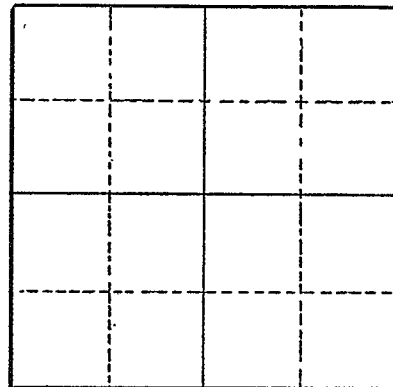

Section

CASING RECORD:

8 inch

FINISH:

Casing perforated 25 to 48

AQUIFERS:

WATER LEVEL:

PUMPING EQUIPMENT: Type Turbine H.P. 5
Capacity G.P.M.

WELL TESTS:

Drawdown ft. after hours G.P.M.

Drawdown ft. after hours G.P.M.

USE OF WATER Domestic, Irrigation Temp. °F. , 19

SOURCE OF INFORMATION USGS

DRILLER or DIGGER

ADDITIONAL DATA:

Log Water Level Measurements Chemical Analysis Aquifer Test

REMARKS: