

STATE ENGINEER  
Salem, Oregon

MARI... 4963

Well Record

STATE WELL NO. 6/3W-21H(1)  
COUNTY Marion  
APPLICATION NO.

OWNER: H. L. Pearcy Nursery


MAILING ADDRESS:

LOCATION OF WELL: Owner's No.

CITY AND STATE:

1/4 1/4 Sec. T. N. S, R. E. W., W.M.

Bearing and distance from section or subdivision corner

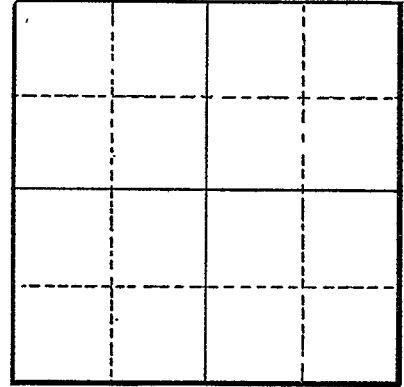

Section

Altitude at well 121

TYPE OF WELL: Drilled Date Constructed 1940

Depth drilled 31 Depth cased

CASING RECORD:

10 inch

FINISH:

Casing perforated

AQUIFERS:

Gravel from 11 to 31

WATER LEVEL:

15 feet

PUMPING EQUIPMENT: Type Centrifugal H.P.

Capacity G.P.M.

WELL TESTS:

Drawdown ft. after hours G.P.M.

Drawdown ft. after hours G.P.M.

USE OF WATER Irrigation Temp. °F., 19

SOURCE OF INFORMATION USGS

DRILLER or DIGGER

ADDITIONAL DATA:

Log Water Level Measurements Chemical Analysis Aquifer Test

REMARKS:

Soil to 2 feet; silt to 11 feet; gravel to 31 feet.