

STATE ENGINEER  
Salem, Oregon

MARI 4.9.60

# Well Record

STATE WELL NO. 6/3W-21J  
COUNTY MARION  
APPLICATION NO. GR-3683

OWNER: Robin D. & Janice E. Day


MAILING ADDRESS: Rt. 2, Box 87

LOCATION OF WELL: Owner's No.

CITY AND STATE: Oregon

NE 1/4 SE 1/4 Sec. 21 T. 6 S., R. 3 W., W.M.

Bearing and distance from section or subdivision corner 1400' N & 700' W from SE cor of Sec 21

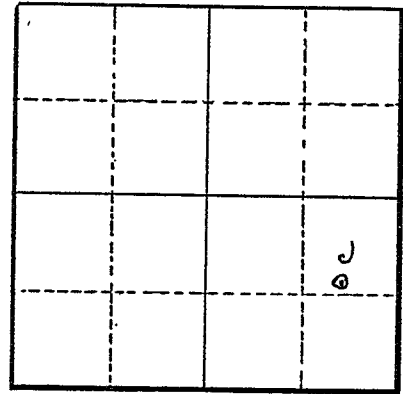

Section 21

Altitude at well

TYPE OF WELL: Drilled Date Constructed 1922

Depth drilled 40' Depth cased 30'

CASING RECORD:

12-inch

FINISH:

Screens at bottom

AQUIFERS:

river soil, sand, gravel

WATER LEVEL:

40'

PUMPING EQUIPMENT: Type

H.P. 15

Capacity 30 G.P.M.

WELL TESTS:

Drawdown ft. after hours 300 G.P.M.

Drawdown ft. after hours G.P.M.

USE OF WATER Irrigation

Temp. °F. 19

SOURCE OF INFORMATION GR-3942

DRILLER or DIGGER

ADDITIONAL DATA:

Log  Water Level Measurements  Chemical Analysis  Aquifer Test

REMARKS:

Plain river bottom soil then sand and gravel 30'