

STATE ENGINEER  
Salem, Oregon

MARI...  
4965

# Well Record

STATE WELL NO. 6/3W-21K(1)  
COUNTY Marion  
APPLICATION NO.

OWNER: H. L. Percy Nursery


MAILING  
ADDRESS:

LOCATION OF WELL: Owner's No.

CITY AND  
STATE:

..... 1/4 ..... 1/4 Sec. ..... T. ..... N. S, R. ..... E. W., W.M.

Bearing and distance from section or subdivision  
corner

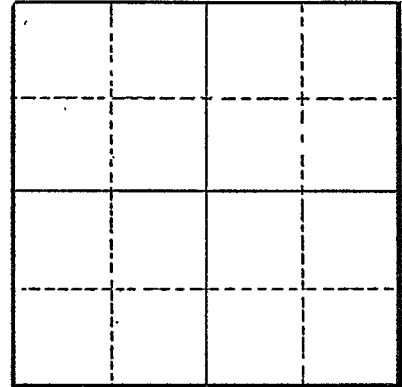

Section

Altitude at well 110

TYPE OF WELL: Drilled Date Constructed 1948

Depth drilled 27 Depth cased

CASING RECORD:

8 inch

FINISH:

Casing perforated

AQUIFERS:

Gravel from 12 to 27

WATER LEVEL:

PUMPING EQUIPMENT: Type Centrifugal H.P. 15

Capacity G.P.M.

WELL TESTS:

Drawdown ft. after hours G.P.M.

Drawdown ft. after hours G.P.M.

USE OF WATER Irrigation Temp. °F. 19

SOURCE OF INFORMATION USGS

DRILLER or DIGGER

ADDITIONAL DATA:

Log  Water Level Measurements Chemical Analysis Aquifer Test

REMARKS:

