


STATE ENGINEER
Salem, Oregon

4966
MARION... Well Record

STATE WELL NO. 6/3W-21K
COUNTY Marion
APPLICATION NO. GR-908

OWNER: Dave Schlag
MAILING ADDRESS: 1385 Clear Lake Road
CITY AND STATE: Salem, Oregon

LOCATION OF WELL: Owner's No.
NW 1/4 SE 1/4 Sec. 21 T. 6 N. S, R. 3 E. W., W.M.
Bearing and distance from section or subdivision
corner 1000 feet South and 660 feet East from
center, Section 21

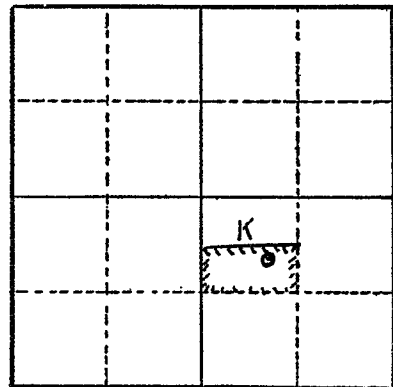

Section 21

Altitude at well 100 feet

TYPE OF WELL: Drilled Date Constructed 1951
Depth drilled 32 feet Depth cased 28 feet

CASING RECORD:

10-inch steel casing set from 0 to 28 feet

FINISH:

1/2" perforations from 18 to 28 feet

AQUIFERS:

gravel at 18 feet

WATER LEVEL:

14 feet

PUMPING EQUIPMENT: Type Centrifugal H.P. 10
Capacity 200 G.P.M.

WELL TESTS:

Drawdown 4 ft. after 160 hours G.P.M.
Drawdown ft. after hours G.P.M.

USE OF WATER Irrigation Temp. °F. 19

SOURCE OF INFORMATION GR-882

DRILLER or DIGGER Howard Evans

ADDITIONAL DATA:

Log (na) Water Level Measurements Chemical Analysis Aquifer Test

REMARKS: