

STATE ENGINEER  
Salem, Oregon

MAR 1 4967

# Well Record

STATE WELL NO. 6/3W-21N(1)  
COUNTY Marion  
APPLICATION NO. GR-1245

GR- 1202

OWNER: Chauncy W. LeVee


MAILING ADDRESS: 3890 N. River Rd.

LOCATION OF WELL: Owner's No.

CITY AND STATE: Salem, Oregon

SW 1/4 SW 1/4 Sec. 21 T. 6 S., R. 3 W., W.M.

Bearing and distance from section or subdivision corner 1.5 ch. N. & 13.5 ch. W. from the SE cor. of SW 1/4 SW 1/4 of Section 21.

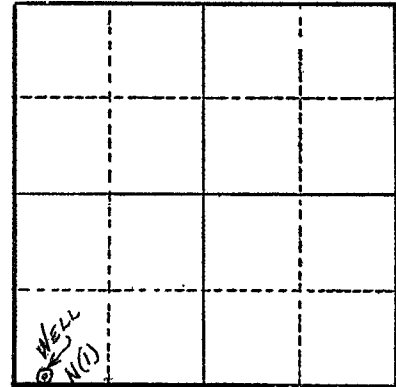

Section 21

Altitude at well 150 ft. 2 120'

TYPE OF WELL: Drilled Date Constructed 1950

Depth drilled 28 ft. Depth cased 28 ft.

CASING RECORD:  
8 inch

FINISH:  
Perforated ( 6 per ft. ) from 20 to 28 ft.

AQUIFERS:

WATER LEVEL:  
17 ft.

PUMPING EQUIPMENT: Type Cent. H.P. 5.75  
Capacity 120 G.P.M.

WELL TESTS:  
Drawdown ft. after hours G.P.M.  
Drawdown ft. after hours G.P.M.

USE OF WATER Irrigation Temp. °F. 19

SOURCE OF INFORMATION G.R. Record

DRILLER or DIGGER

ADDITIONAL DATA:

Log Water Level Measurements Chemical Analysis Aquifer Test

REMARKS:

Log: Top soil 0 to 6 ft.  
River gravel 6 to 28 ft.

Irrigation of 21 acres.