

STATE ENGINEER
Salem, Oregon

4968
MARI.....

Well Record

STATE WELL NO. 16/3W- 21Q
COUNTY MARION
APPLICATION NO. GR-3682

OWNER: Robin D. Day & Janice E. Day


MAILING ADDRESS: Rt 2 Box 87

LOCATION OF WELL: Owner's No.

CITY AND STATE: Salem, Ore

SW 1/4 SE 1/4 Sec. 21 T. 6 S., R. 3 W., W.M.

Bearing and distance from section or subdivision corner 2040' W & 1290' N from SE cor Sec 21

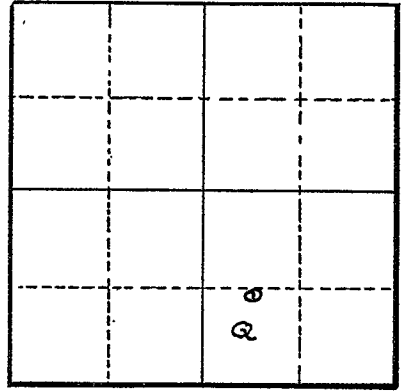

Section 21

Altitude at well

TYPE OF WELL: Drilled Date Constructed 1942

Depth drilled 40' Depth cased 40'

CASING RECORD:

6-inch

FINISH:

screens at bottom

AQUIFERS:

river soil, sand, gravel

WATER LEVEL:

PUMPING EQUIPMENT: Type _____ H.P. 5
Capacity 200 G.P.M.

WELL TESTS:
Drawdown _____ ft. after _____ hours 200 G.P.M.
Drawdown _____ ft. after _____ hours _____ G.P.M.

USE OF WATER Irrigation Temp. _____ °F. _____, 19
SOURCE OF INFORMATION GR-3941

DRILLER or DIGGER _____
ADDITIONAL DATA:
Log Water Level Measurements _____ Chemical Analysis _____ Aquifer Test _____

REMARKS:

Plain river bottom soil then sand and gravel 30'