

STATE ENGINEER
Salem, Oregon

5076
MARION

Well Record

GR- 1749

STATE WELL NO. 6/3W-23F (1)
COUNTY Marion
APPLICATION NO. GR- 1808

OWNER: Harvey E. Evans


MAILING ADDRESS: 7855 Wheatland Rd.

LOCATION OF WELL: Owner's No.

CITY AND STATE: Salem, Oregon

SE 1/4 NW 1/4 Sec. 23 T. 6 N. S. R. 3 W., W.M.

Bearing and distance from section or subdivision corner 676.15' N. & 690' W. of Center Sec. 23

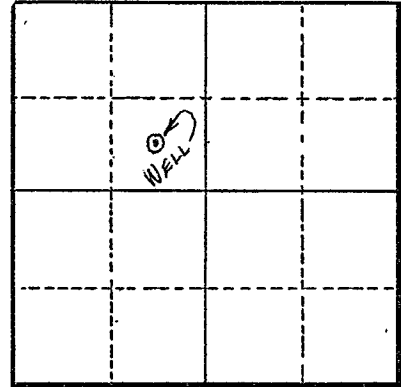

Section 23

Altitude at well 110'

TYPE OF WELL: Drilled Date Constructed 1948

Depth drilled 52' Depth cased 50'

CASING RECORD:

12" from 12 to 50 ft.

FINISH:

?

AQUIFERS:

WATER LEVEL:

15'

PUMPING EQUIPMENT: Type Cent. H.P. 15

Capacity 800 G.P.M.

WELL TESTS:

Drawdown 12 ft. after 800 hours G.P.M.

Drawdown ft. after hours G.P.M.

USE OF WATER Irrigation Temp. °F. 19

SOURCE OF INFORMATION GR Record

DRILLER or DIGGER H. E. Evans

ADDITIONAL DATA:

Log Water Level Measurements Chemical Analysis Aquifer Test

REMARKS:

Log: Silt 0 to 12 ft.
Gravel 12 to 52 ft.

Irrigation of 40.05 acres.