

STATE ENGINEER
Salem, Oregon

5079
MARI.....79

Well Record


STATE WELL NO. 6/3W-23J
COUNTY Marion
APPLICATION NO. GR-907

OWNER: Dave Schlag
MAILING ADDRESS: 1385 Clear Lake Road

LOCATION OF WELL: Owner's No. CITY AND STATE: Salem, Oregon

NE 1/4 SE 1/4 Sec. 23 T. 6 N. S. R. 3 E. W., W.M.

Bearing and distance from section or subdivision corner 1200 feet West and 200 feet North from the E/4 Corner

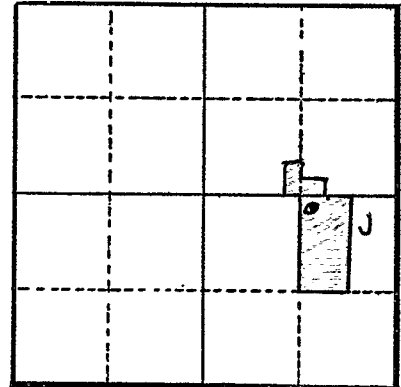

Section 23

Altitude at well 185 feet

TYPE OF WELL: Drilled Date Constructed Feb. 1953

Depth drilled 118 feet Depth cased 115 feet

CASING RECORD:

10-inch steel casing from 0 to 115 feet

FINISH:

10-feet 1/2" perforations 70-80

AQUIFERS:

WATER LEVEL:

54 feet

PUMPING EQUIPMENT: Type Berkley-Turbine H.P. 10
Capacity 275 G.P.M.

WELL TESTS:

Drawdown 84 ft. after 385 hours G.P.M.
Drawdown 59 ft. after 150 hours G.P.M.

USE OF WATER Irrigation 20 Temp. °F. 19

SOURCE OF INFORMATION GR-881

DRILLER or DIGGER Wymore

ADDITIONAL DATA:

Log (NA) Water Level Measurements Chemical Analysis Aquifer Test

REMARKS: