

MARI  
5080

# Well Record

STATE WELL NO. 6/3W-23J  
COUNTY Marion  
APPLICATION NO. GR-3285

OWNER: Richard F. Bahnsen


MAILING ADDRESS: 1620 Clear Lake Road

LOCATION OF WELL: Owner's No.

CITY AND STATE: Salem, Oregon

NE NE 1/4 SE 1/4 Sec. 23 T. 6 S., R. 3 W., W.M.

Bearing and distance from section or subdivision corner 62.5' E. & 112' S. from 1/4 Corner on E. line Section 23

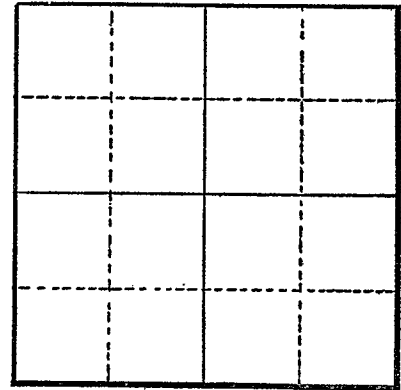

Section

Altitude at well

TYPE OF WELL: drilled Date Constructed 1950

Depth drilled 97' Depth cased 97'

### CASING RECORD:

6"

### FINISH:

### AQUIFERS:

### WATER LEVEL:

60'

PUMPING EQUIPMENT: Type Jet H.P. 2 1/2  
Capacity 50 G.P.M.

### WELL TESTS:

Drawdown ft. after hours pumping 100 G.P.M.  
Drawdown ft. after hours G.P.M.

USE OF WATER Irrigation Temp. °F., 19

SOURCE OF INFORMATION GR-3054

DRILLER or DIGGER Irving Sears

### ADDITIONAL DATA:

Log Water Level Measurements Chemical Analysis Aquifer Test

### REMARKS: