

STATE ENGINEER  
Salem, Oregon

5082  
MARL

# Well Record

STATE WELL NO. 6/3W-23K  
COUNTY Marion  
APPLICATION NO. GR-3595

OWNER: John E. Lepper & Sons


MAILING ADDRESS: 1530 Clear Lake Rd.

LOCATION OF WELL: Owner's No.

CITY AND STATE: Salem, Oregon

NW 1/4 SE 1/4 Sec. 23 T. 6 S, R. 3 W, W.M.

Bearing and distance from section or subdivision  
corner 268' W. and 588' S. of NE cor. of W 1/2 of SE 1/4

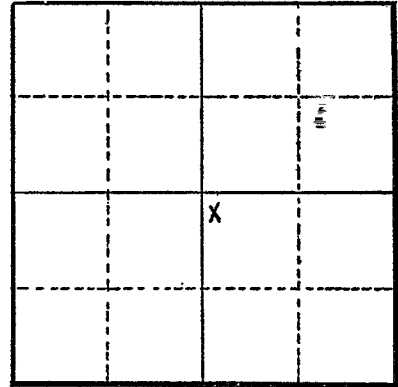

Section 23

Altitude at well

TYPE OF WELL: Drilled Date Constructed June, 1952

Depth drilled 107 ft. Depth cased 107 ft.

### CASING RECORD:

5 inch casing set to 107 feet

### FINISH:

### AQUIFERS:

### WATER LEVEL:

57 feet below surface

PUMPING EQUIPMENT: Type Jacuzzi turbine H.P. 5

Capacity 100 G.P.M.

### WELL TESTS:

Drawdown ft. after hours G.P.M.

Drawdown ft. after hours G.P.M.

USE OF WATER Irrigation Temp. °F. 19

SOURCE OF INFORMATION Well Registration Statement

DRILLER or DIGGER Harvey Evans

### ADDITIONAL DATA:

Log Water Level Measurements Chemical Analysis Aquifer Test

### REMARKS: