

STATE ENGINEER
Salem, Oregon

Well Record

STATE WELL NO. 4/1W-11A(1)
COUNTY Marion
APPLICATION NO. GR-50

MARI 510
ARDEE

OWNER: George ~~Ardee~~


MAILING ADDRESS: Rt. 1 Box 272

LOCATION OF WELL: Owner's No. _____

CITY AND STATE: Aurora

NE 1/4 NE 1/4 Sec. 14 T. 4 N. S., R. 1 E. W., W.M.

Bearing and distance from section or subdivision corner Approx. 1250' W. & 150' S. from NW cor. Sec. 14, T. 4 S., R. 1 W.

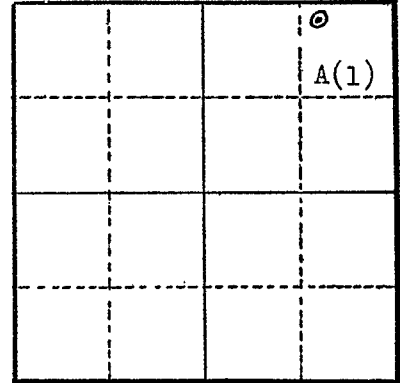

Section 14

Altitude at well 175

TYPE OF WELL: Drilled Date Constructed 7-13-50

Depth drilled 118 Depth cased 102

CASING RECORD:

10 inch

FINISH:

AQUIFERS:

WATER LEVEL:

25

PUMPING EQUIPMENT: Type Peerless Turbine H.P. 20
Capacity 350 G.P.M.

WELL TESTS:

Drawdown _____ ft. after _____ hours _____ G.P.M.
Drawdown _____ ft. after _____ hours _____ G.P.M.

USE OF WATER Irrigation Temp. _____ °F., 19

SOURCE OF INFORMATION J. T. MILLER

DRILLER or DIGGER _____

ADDITIONAL DATA:

Log Water Level Measurements _____ Chemical Analysis _____ Aquifer Test _____

REMARKS:

