

STATE ENGINEER
Salem, Oregon

511
MARION

Well Record

STATE WELL NO. 4/W - 14B
COUNTY MARION
APPLICATION NO. GR-2004

OWNER: Eugene C. Cole


MAILING ADDRESS: Route 1

LOCATION OF WELL: Owner's No.

CITY AND STATE: Aurora, Oregon

NW 1/4 NE 1/4 Sec. 14 T. 4 S., R. 1 W., W.M.

Bearing and distance from section or subdivision corner 100' S. and 780' E.

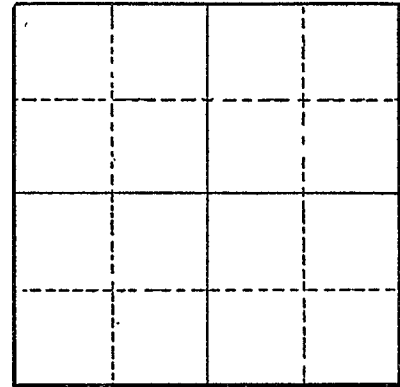

Section

Altitude at well

TYPE OF WELL: Drilled Date Constructed 1952

Depth drilled 132 Depth cased 106

CASING RECORD:

10-inch

FINISH:

Perforation from 98 to 104

AQUIFERS:

Clay

WATER LEVEL:

29-feet

PUMPING EQUIPMENT: Type Peerless Turbine H.P. 15
Capacity 275 G.P.M.

WELL TESTS:
Drawdown 90 ft. after hours Pumping 320 G.P.M.
Drawdown ft. after hours G.P.M.

USE OF WATER Irrigation & Domestic Temp. °F., 19.

SOURCE OF INFORMATION GR-1934

DRILLER or DIGGER

ADDITIONAL DATA:

Log Water Level Measurements Chemical Analysis Aquifer Test

REMARKS:

